

Mechanical Handling Data Sheet

Top Running, Double Girder

 CM

Data Sheet No.

24590-HLW-M0D-HEH-00025

Plant Item No.

24590-HLW-MJ-HEH-CRN-00003

Project		RPP-WTP		Descriptio	n		Canister Sta	rage Crana	
Project No.		24590		Supporting Calculation No.		Canister Storage Crane			
Planning Area		1.000		Associated Drawing No.		N/A 4 I		R10704040	
System No.		HEH			d Specifica			P-3PS-MJKG-T0003	
Building No.		30	······································		d MR No.			RA-MJKG-00002	
Quality Level		► CM 4		, reconstant	a mire ito.		24330-QL-IVI	· · · · · · · · · · · · · · · · · · ·	
Seismic Criteria	a	SC-II	· · · · · · · · · · · · · · · · · · ·					ISSUI	
Function		 	ndling, Storage, and N	Maintenance	Activities		\\\\	RPP-W	TP PDC
			, , , , , , , , , , , , , , , , , , , ,		7 totte kiloc			<u> </u>	
DESIGN CRITE	ERIA			····					
Design Life		40 years		Safety Cla	ssification	1	► APC /4	\	
						- L			
OPERATING E	NVIRONME	NT		In-Cave	Rm # H-0	132	Out-Cave	Rm # H-313B	List All Special
				Min	Max		Min	Max	Conditions
Temperature			deg F	59	113		59	113	
Relative Humidi	lity		%	0	70		0	70	
Radiological Equ	quip. Dose	gamma	mrad/hr	▶4.0*E+4	4		▶ 100 👍	7	
		neutron mrad/hr		Negligible			Negligible		
Radiological Cla			· · · · · · · · · · · · · · · · · · ·	R5			►R3/R5 👍		
Contamination (Classification	1		C3			►C3 <u>4</u>	7	
ODANE TEST	in branching	***					-14.		
CRANE REQUI	IREMENTS		<u></u>					·	
Type of Crane	ntion		Top Running Double		tric Overh		Crane	Tons	
Service Informat			CMAA 70-2000, Cla	ss E		Capacity		6 Ton	
Crane Operation			Yes, In-Cave			Main Hoist		6 Ton	
Class Informatio	laterial Handled Canisters		Class E			Auxiliary Hois	***		
			1			Trolley		6 Ton	
ASCE Rail Type			lo. of Cranes Required 1			Bridge		6 Ton	
loist- Range of	HARACTER Lift		► 104 lb/yd Crane F FREQUENCY OF MC (F) - (G) 1/2 Runway Length			No. lifts/day		6	
Hoist- Range of Average Moves Average Moves	HARACTER Lift - Bridge - Trolley	ISTICS AND F	FREQUENCY OF MC (F) - (G) 1/2 Runway Length 3/4 Bridge Length			No. lifts/day			

























Mechanical Handling Data Sheet

Top Running, Double Girder

Data Sheet No.

24590-HLW-M0D-HEH-00025

Plant Item No.

24590-HLW-MJ-HEH-CRN-00003

4

4

DRIVE TYPE SPEED AND HORSEPOWER

Drives	Drive Type	Speed	Horsepower		Slow	Fast
Main Hoist Drive Type	Flux Vector	Variable 0 - 25	12 HP	Nominal Speed (ft/m):	5	25
Recovery Hoist Drive Type	Single Speed	Single Speed	7 HP	Nominal Speed (ft/m):	5	
Main Bridge Drive Type	VFD	Variable 0 - 50	4 HP	Nominal Speed (ft/m):	5	50
Recovery Bridge Drive Type	Single Speed	Single Speed	1 HP	Nominal Speed (ft/m):	5	
Main Trolley Drive Type	VFD	Variable 0-25	1.5 HP	Nominal Speed (ft/m):	5	25
Recovery Trolley Drive Type	Single Speed	Single Speed	0.75 HP	Nominal Speed (ft/m):	5	
Powered Hook	DC Motor	Fixed	0.05 HP	Nominal Speed (rpm):	1-2	

CONDUCTOR TYPE

Bridge	Cable Reel
Trolley	Cable Track

CONTROLS

Method of Control	Manual
Location of Control	Dedicated Crane Control Room/ Window Station/ Crane Maintenance Area
Type of Control Enclosure	NEMA 4X or IP 66

ELECTRICAL REQUIREMENTS

INDIA INE CONCENIENTO		
Item	Volts / Phase / Hertz	
Motor	480 VAC / 3 Phase / 60 HZ	The state of the s
Special Wiring Conditions	National Electric Code	V

MAINTENANCE REQUIREMENTS

Construction	Modular for ease of assembly / dismantling	
Modularization	Heaviest Modular item except bridge beams / end trucks / must be < 5 tons.	
Retrieval	Crane must be retrievable / Hoist must be retrievable	
Decontamination	Crane and hoist needs to be decontaminable and minimize cracks and crevices that can trap debris	

ADDITIONAL REQUIREMENTS (NOTES):

- 1. Motors and electrical cabinets etc. to be sealed to withstand occasional washdown during decontamination.
- 2. Four bridge mounted and two trolley mounted cameras capable of pan, zoom, iris and tilt and one hook deployed camera including lighting, pan, tilt, zoom and iris to view cave floors. The Buyer supplies the cameras, Seller provides mounts.
- 3. All cranes shall be designed to allow operator positioning to within +/- 3/8"
- 4. Four crane mounted lights as well as light supplied by cameras.
- Must be able to hold and control suspended payload without mechanical braking for sustained periods.
- Must not drop load during any single random or common mode electrical failure.
- 7. Must be recoverable by remote means after any specified single random or common mode failure by use of redundant drives in conjunction with cable reel where necessary.
- 8. Power supply is required at hook for crane held tools.
- Motor horsepower estimated for plant electrical load sizing. Seller to provide.
- 10. This drawing provided basic outlines, design objectives, and bounding dimensions to contracted design or fabrication supplier(s) and shall not be used to confirm the as built WTP structure, system or component identified herein. See vendor information for final configuration provided in conformance to purchase order QL-POA-MJKG-00002.
- ► 11. Revision 1 changes: Changed additional requirements, drives, and description

 12. Revision 2 changes: Changed low hook height and range of lift
- ► 13. Revision 3 changes: Changed rad levels, drive types and editorial changes.
- ▶ 14. Revision 3 changes: Safety Classification changed to APC; Quality Level changed to CM; Calc ref deleted; Dimension K & M ammended to include bumper extensions that allow bumpers to engage on cave wall, IAW 24590-HLW-ACA-M-05-00031

Doc Number 24590-HLW-M0D-HEH-00025 REV 4 Page 2 of



Mechanical Handling Data Sheet

Top Running, Double Girder


Data Sheet No.

24590-HLW-M0D-HEH-00025

Plant Item No.

24590-HLW-MJ-HEH-CRN-00003

Rev.

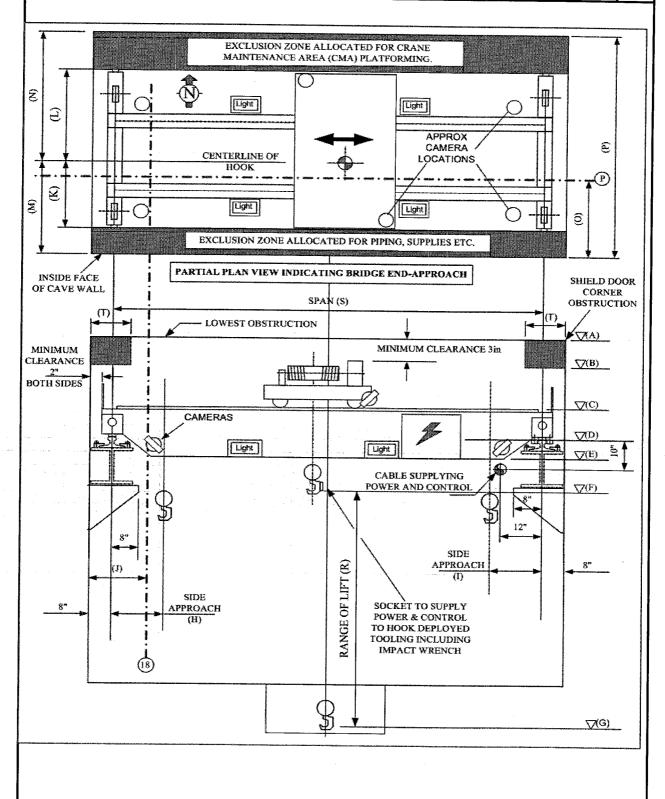

4

3